




PRODUCT NO.
SFV__R-1STE1HLF
<del>SFV__R-1STAE1HLF</del>
SFV__R-1STBE1HLF

OBSOLETE

CAT. NO. & DIMENSIONS

NO. OF CONT (n)	CAT. NO.	DIMENSIONS		
		E	F	G
4	SFV4R-1ST_E1HLF	22.4	16	—
5	SFV5R-1ST_E1HLF	22.4	16	—
6	SFV6R-1ST_E1HLF	22.4	16	—
7	SFV7R-1ST_E1HLF	30.4	24	—
8	SFV8R-1ST_E1HLF	30.4	24	—
9	SFV9R-1ST_E1HLF	30.4	24	—
10	SFV10R-1ST_E1HLF	30.4	24	—
11	SFV11R-1ST_E1HLF	30.4	24	—
12	SFV12R-1ST_E1HLF	30.4	24	—
13	SFV13R-1ST_E1HLF	30.4	24	—
14	SFV14R-1ST_E1HLF	30.4	24	—
15	SFV15R-1ST_E1HLF	30.4	24	—
16	SFV16R-1ST_E1HLF	30.4	24	—
17	SFV17R-1ST_E1HLF	30.4	24	—
18	SFV18R-1ST_E1HLF	30.4	24	—
19	SFV19R-1ST_E1HLF	30.4	24	—
20	SFV20R-1ST_E1HLF	30.4	24	—
21	SFV21R-1ST_E1HLF	30.4	24	—
22	SFV22R-1ST_E1HLF	30.4	24	—
23	SFV23R-1ST_E1HLF	38.4	32	28.4
24	SFV24R-1ST_E1HLF	38.4	32	28.4
25	SFV25R-1ST_E1HLF	38.4	32	28.4
26	SFV26R-1ST_E1HLF	38.4	32	28.4
27	SFV27R-1ST_E1HLF	38.4	32	28.4
28	SFV28R-1ST_E1HLF	38.4	32	28.4
29	SFV29R-1ST_E1HLF	38.4	32	28.4
30	SFV30R-1ST_E1HLF	38.4	32	28.4
31	SFV31R-1ST_E1HLF	50.4	44	40.4
32	SFV32R-1ST_E1HLF	50.4	44	40.4
33	SFV33R-1ST_E1HLF	50.4	44	40.4
34	SFV34R-1ST_E1HLF	50.4	44	40.4
35	SFV35R-1ST_E1HLF	50.4	44	40.4

FOR E1 PACKAGING OPTION

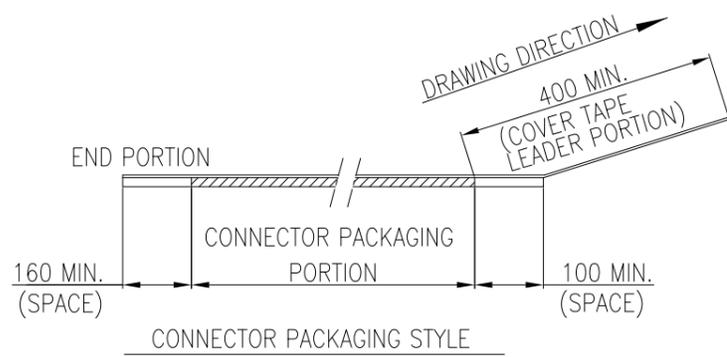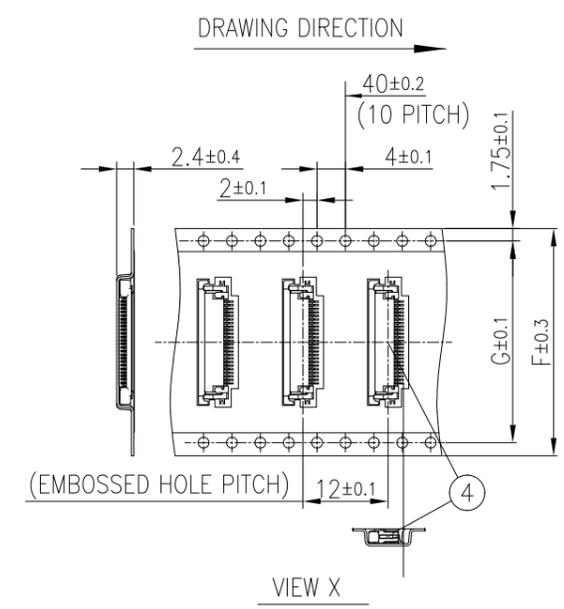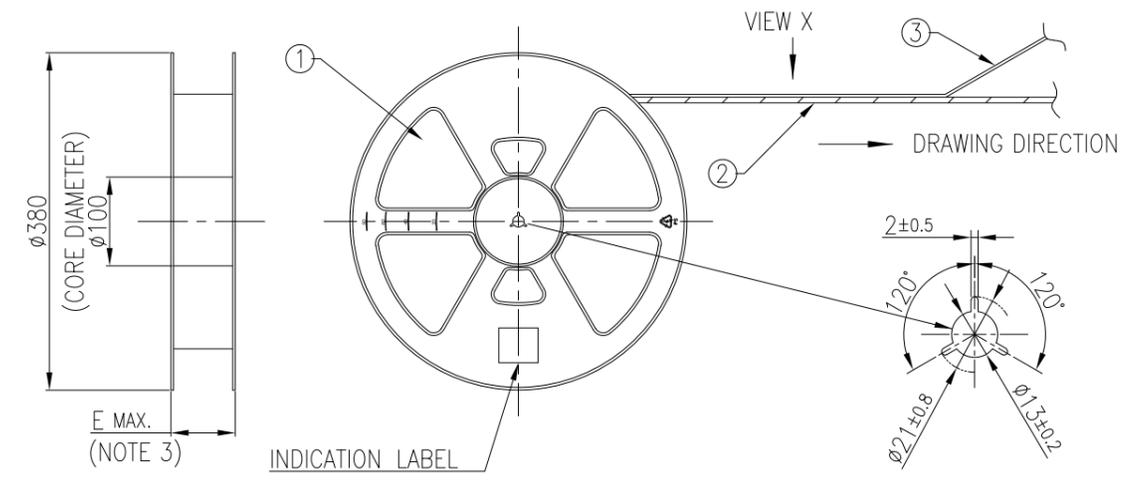

MATERIAL TABLE

PT. NO.	PARTS NAME	CAT. NO.	MATERIAL	COLOR
1	REEL		POLYSTYRENE	BLACK
2	EMBOSS TAPE	—	PS	TRANSPARENT
3	COVER TAPE	—	POLYESTER,POLYETHYLENE	TRANSPARENT
4	CONNECTOR	SFV__R-1ST__HLF	SEE SHEET 2	

PACKAGING OPTION TABLE

PRODUCT NUMBER	PACKAGING OPTION	REEL MATERIAL	REEL DIAMETER	CONNECTOR QUANTITY
SFV__R-1STE1HLF	E1	PLASTIC	ø380	3000 / REEL
<del>SFV__R-1STAE1HLF</del>				
SFV__R-1STBE1HLF				




NOTES

- THIS IS PLASTIC TAPE PACKAGED CONNECTOR DESIGNED TO TERMINATE FPC/FFC AND COPES WITH AUTOMATIC MOUNTING (SMT).
- SEE JIS C 0806 (PACKING OF ELECTRONIC COMPONENTS ON CONTINUOUS TAPES (SURFACE MOUNTING DEVICES)) FOR SHAPE AND DIMENSIONS OF PLASTIC (EMBOSS) TAPE AND REEL.
- E DIMENSION IS PORTION OF THE CORE.

mat'l. code SEE_TABLE		surface ISO 1302 <input checked="" type="checkbox"/>		tolerance ISO 406 ISO 1101		projection 		product family 58EF	
ltr		ecn no		dr		date		title PLASTIC TAPE PACKAGED 0.5MM CONTACT SPACING CONNECTOR (Cat. No. SFV__R-1ST_E1HLF)	
A				S.W.		2023-12-21		MM	
B		ELX-J-52124		S.W.		2024-07-12			
				angles		linear		scale N/A	
				0°±5'		0.XX/±0.5			
				dr		S.WATANABE		Amphenol FCi	
				enr		2024-07-12			
				chr		AN.MOHAMMAD-NABEEL			
				appd		Y.KAMEDA			
sheet index		revision sheet		B B		B B B B		dwg no 10171070	
		1 2		3 4		5 6		sheet 1 of 6 size A3	
								type PRODUCT CUSTOMER DRAWING	

PRODUCT NO.
SFV__R-1ST__HLF
SFV__R-1STA__HLF
SFV__R-1STB__HLF

OBSOLETE

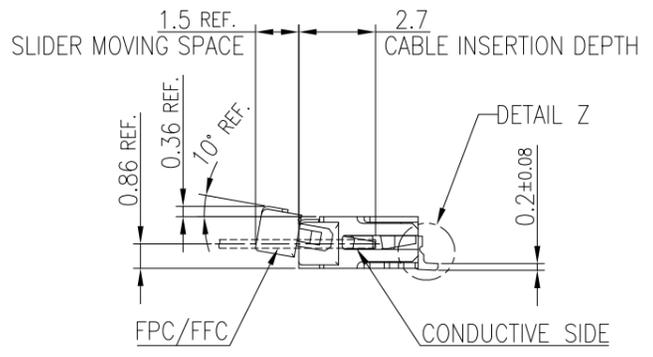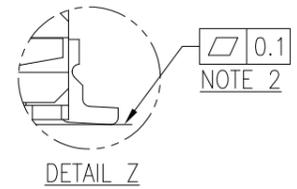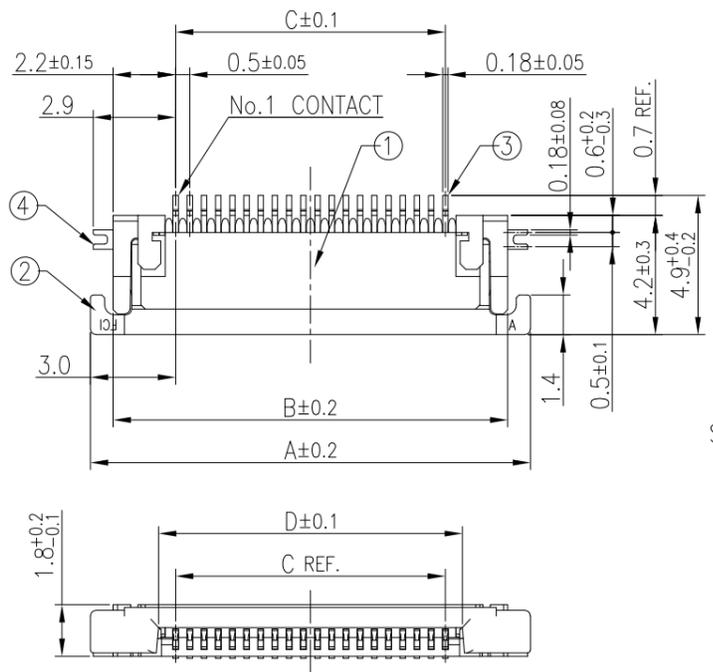

CAT. NO. & DIMENSIONS

NO. OF CONT (n)	CAT. NO.	DIMENSIONS			
		A	B	C	D
4	SFV4R-1ST__HLF	7.5	5.9	1.5	2.7
5	SFV5R-1ST__HLF	8.0	6.4	2.0	3.2
6	SFV6R-1ST__HLF	8.5	6.9	2.5	3.7
35	SFV35R-1ST__HLF	23.0	21.4	17.0	18.2

MATERIAL TABLE

PT. NO.	PARTS NAME	MATERIAL	Q'TY	NOTE
1	HOUSING	13~35pin : LCP RESIN GLASS REINFORCED (UL94V-0)	1	COLOR : BLACK (HALOGEN FREE)
		4~12pin : POLYAMIDE RESIN GLASS REINFORCED (UL94V-0)		
2	SLIDER	PPS RESIN GLASS REINFORCED (UL94V-0)	1	COLOR : BLACK (HALOGEN FREE)
3	CONTACT	PHOSPHOR BRONZE	n	PLATING : SEE PLATING OPTION (LEAD FREE)
4	MOUNTING PLATE		2	PLATING : MATTE TIN 1.5um min (LEAD FREE) NICKEL UNDER PLATING 1.27um min.

n : NO. OF CONTACTS


NOTES

- THIS PRODUCT IS THE BOTTOM CONTACT TYPE CONNECTOR DESIGNED TO TERMINATE FPC/FFC AND COPES WITH AUTOMATIC MOUNTING (SMT).
- FLATNESS OF CONTACT TERMINAL AND MOUNTING PLATE TO HOUSING MUST BE WITHIN TOLERANCE IN Z PORTION DETAILED DRAWING.
- THIS PRODUCT MEETS EUROPEAN UNION DIRECTIVES AND OTHER COUNTRY REGULATIONS AS DESCRIBED IN GS47-0004.
- THE HOUSING WILL WITHSTAND EXPOSURE TO 260°C PEAK TEMPERATURE FOR 10 SECONDS IN A REFLOW SOLDERING OVEN.
- APPLICATION SPEC : BJM-SFV101. PRODUCT SPEC : REFER TO PLATING OPTION TABLE.
- CATALOG NUMBER STRUCTURE IS AS FOLLOWINGS.

PLATING OPTION TABLE

OBSOLETE

PRODUCT NUMBER	PLATING OPTION	CONTACT PLATING	TERMINAL PLATING	PRODUCT SPEC
SFV__R-1ST__HLF	BRANK	MATTE THIN TIN PLATING	MATTE TIN : 1um min.	GS-12-645
SFV__R-1STA__HLF	A	GOLD : 0.05um min.	MATTE TIN : 1.5um min.	SC-SFV08
SFV__R-1STB__HLF	B	GOLD : 0.05um min. WITH Ni DAM	GOLD : 0.05um min.	SC-SFV08

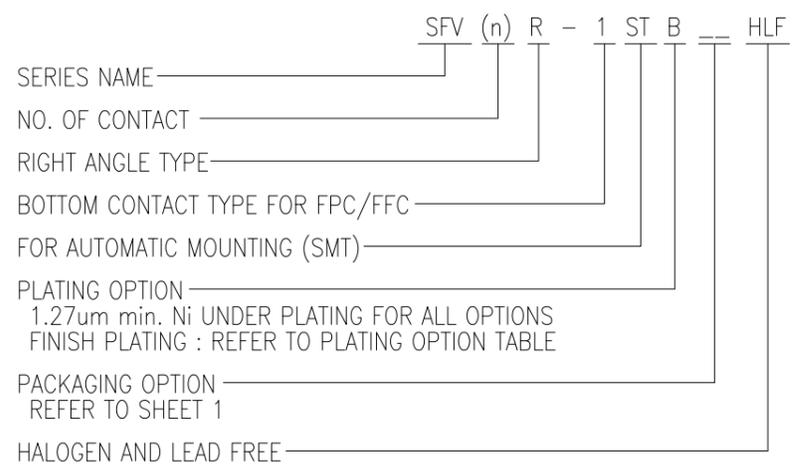

mat'l. code	surface	tolerance	projection	product family
SEE_TABLE	ISO 1302 <input checked="" type="checkbox"/> ISO 406 ISO 1101	ISO 1302 <input checked="" type="checkbox"/> ISO 406 ISO 1101		58EF
ltr	ecn no	dr	date	title
B				CONNECTOR USED FOR FPC/FFC WITH 0.5MM CONTACT SPACING (Cat. No. SFV__R-1ST__HLF)
tolerances unless otherwise specified				MM
angles linear				scale 4:1
0°±2'				
dr				S.WATANABE 2024-07-12
enr				S.WATANABE 2024-07-12
chr				AN.MOHHAMAD-NABEEL 2024-07-12
appd				Y.KAMEDA 2024-07-12
sheet index		revision sheet		dwg no
				10171070
				sheet 2 of 6
				size A3
				type PRODUCT CUSTOMER DRAWING

Amphenol FCI




© 2016 AFCI

Amphenol FCI

PRODUCT NO.
SFV__R-2STE1HLF
<del>SFV__R-2STAE1HLF</del>
SFV__R-2STBE1HLF

OBSOLETE

FOR E1 PACKAGING OPTION

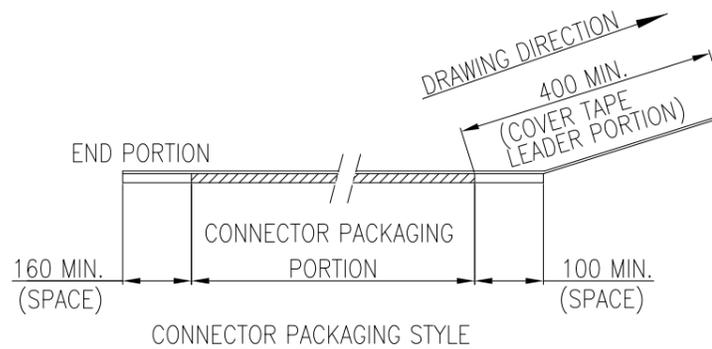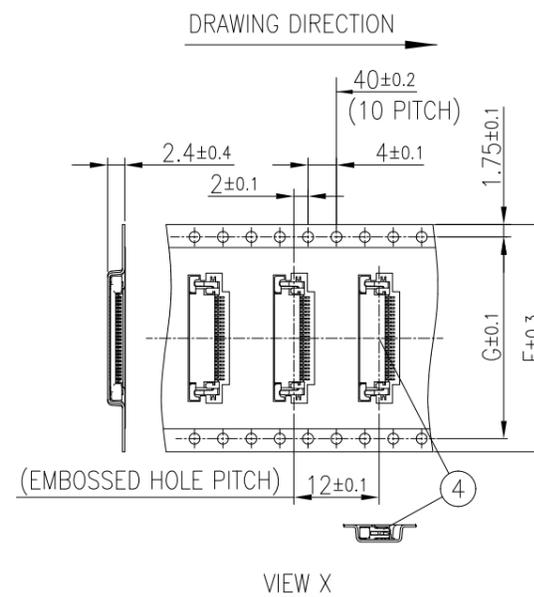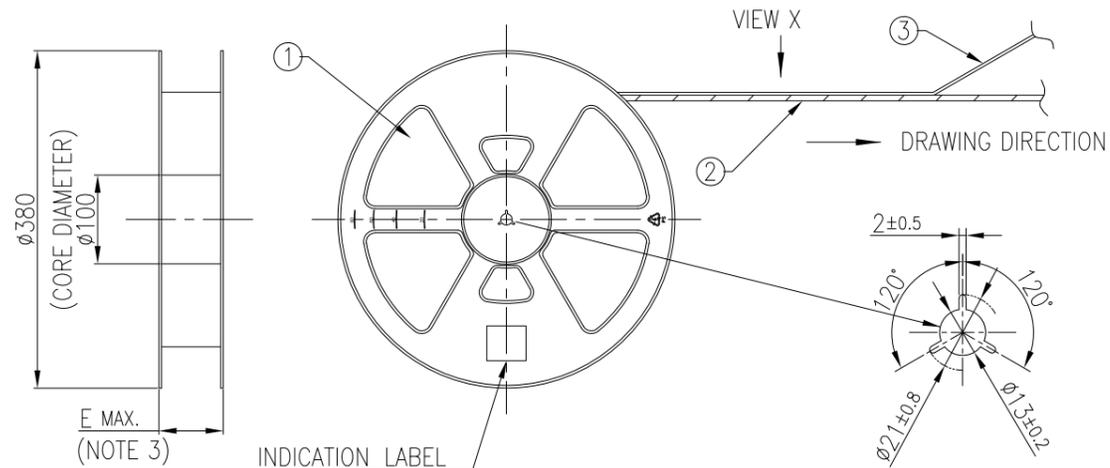

CAT. NO. & DIMENSIONS

NO. OF CONT (n)	CAT. NO.	DIMENSIONS		
		E	F	G
4	SFV4R-2ST_E1HLF	22.4	16	—
5	SFV5R-2ST_E1HLF	22.4	16	—
6	SFV6R-2ST_E1HLF	22.4	16	—
7	SFV7R-2ST_E1HLF	30.4	24	—
8	SFV8R-2ST_E1HLF	30.4	24	—
9	SFV9R-2ST_E1HLF	30.4	24	—
10	SFV10R-2ST_E1HLF	30.4	24	—
11	SFV11R-2ST_E1HLF	30.4	24	—
12	SFV12R-2ST_E1HLF	30.4	24	—
13	SFV13R-2ST_E1HLF	30.4	24	—
14	SFV14R-2ST_E1HLF	30.4	24	—
15	SFV15R-2ST_E1HLF	30.4	24	—
16	SFV16R-2ST_E1HLF	30.4	24	—
17	SFV17R-2ST_E1HLF	30.4	24	—
18	SFV18R-2ST_E1HLF	30.4	24	—
19	SFV19R-2ST_E1HLF	30.4	24	—
20	SFV20R-2ST_E1HLF	30.4	24	—
21	SFV21R-2ST_E1HLF	30.4	24	—
22	SFV22R-2ST_E1HLF	30.4	24	—
23	SFV23R-2ST_E1HLF	38.4	32	28.4
24	SFV24R-2ST_E1HLF	38.4	32	28.4
25	SFV25R-2ST_E1HLF	38.4	32	28.4
26	SFV26R-2ST_E1HLF	38.4	32	28.4
27	SFV27R-2ST_E1HLF	38.4	32	28.4
28	SFV28R-2ST_E1HLF	38.4	32	28.4
29	SFV29R-2ST_E1HLF	38.4	32	28.4
30	SFV30R-2ST_E1HLF	38.4	32	28.4
31	SFV31R-2ST_E1HLF	50.4	44	40.4
32	SFV32R-2ST_E1HLF	50.4	44	40.4
33	SFV33R-2ST_E1HLF	50.4	44	40.4
34	SFV34R-2ST_E1HLF	50.4	44	40.4
35	SFV35R-2ST_E1HLF	50.4	44	40.4

MATERIAL TABLE

PT. NO.	PARTS NAME	CAT. NO.	MATERIAL	COLOR
1	REEL		POLYSTYRENE	BLACK
2	EMBOSS TAPE	—	PS	TRANSPARENT
3	COVER TAPE	—	POLYESTER,POLYETHYLENE	TRANSPARENT
4	CONNECTOR	SFV__R-2ST__HLF	SEE SHEET 4	

PACKAGING OPTION TABLE




PRODUCT NUMBER	PACKAGING OPTION	REEL MATERIAL	REEL DIAMETER	CONNECTOR QUANTITY
SFV__R-2STE1HLF	E1	PLASTIC	φ380	3000 / REEL
<del>SFV__R-2STAE1HLF</del>				
SFV__R-2STBE1HLF				

NOTES

- THIS IS PLASTIC TAPE PACKAGED CONNECTOR DESIGNED TO TERMINATE FPC/FFC AND COPES WITH AUTOMATIC MOUNTING (SMT).
- SEE JIS C 0806 (PACKING OF ELECTRONIC COMPONENTS ON CONTINUOUS TAPES (SURFACE MOUNTING DEVICES)) FOR SHAPE AND DIMENSIONS OF PLASTIC (EMBOSSED) TAPE AND REEL.
- E DIMENSION IS PORTION OF THE CORE.

mat'l. code SEE_TABLE		surface ISO 1302 ✓	tolerance ISO 406 ISO 1101	projection 	product family 58EF
ltr	ecn no	dr	date	tolerances unless otherwise specified	title PLASTIC TAPE PACKAGED 0.5MM CONTACT SPACING CONNECTOR (Cat. No. SFV__R-2ST_E1HLF)
B				angles linear 0°±5'	
				0.X/±0.5 0.XX/±0.5 0.XXX/±0.5	
		dr	S.WATANABE	2024-07-12	dwg no sheet 3 of 6 size A3
		enr	S.WATANABE	2024-07-12	
		chr	AN.MOHAMMAD-NABEEL	2024-07-12	
		app	Y.KAMEDA	2024-07-12	
sheet index	revision sheet				type PRODUCT CUSTOMER DRAWING

PRODUCT NO.
SFV__R-2ST__HLF
SFV__R-2STA__HLF
SFV__R-2STB__HLF

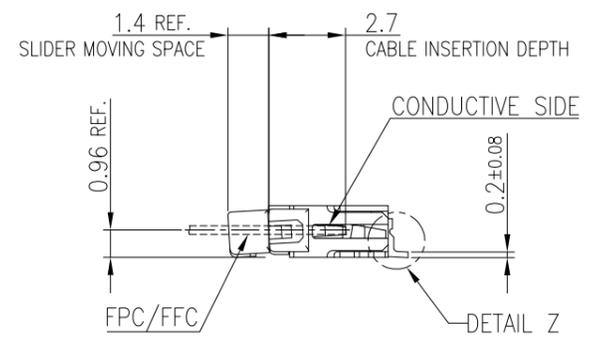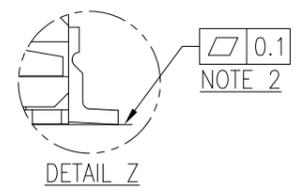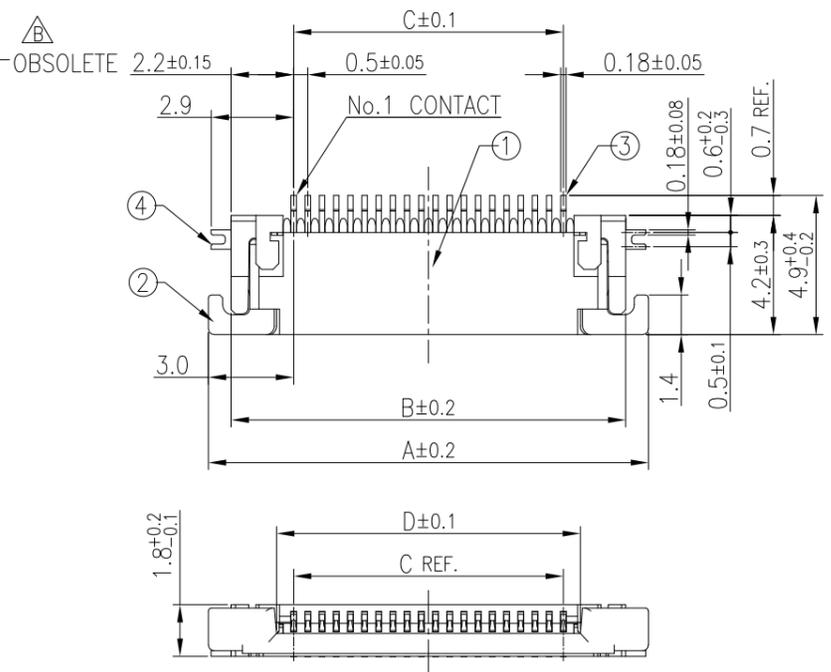

CAT. NO. & DIMENSIONS

NO. OF CONT (n)	CAT. NO.	DIMENSIONS			
		A	B	C	D
4	SFV4R-2ST__HLF	7.5	5.9	1.5	2.7
5	SFV5R-2ST__HLF	8.0	6.4	2.0	3.2
6	SFV6R-2ST__HLF	8.5	6.9	2.5	3.7
35	SFV35R-2ST__HLF	23.0	21.4	17.0	18.2

MATERIAL TABLE

PT. NO.	PARTS NAME	MATERIAL	Q'TY	NOTE
1	HOUSING	13~35pin : LCP RESIN GLASS REINFORCED (UL94V-0)	1	COLOR : BLACK (HALOGEN FREE)
		4~12pin : POLYAMIDE RESIN GLASS REINFORCED (UL94V-0)		
2	SLIDER	PPS RESIN GLASS REINFORCED (UL94V-0)	1	COLOR : BLACK (HALOGEN FREE)
3	CONTACT	PHOSPHOR BRONZE	n	PLATING : SEE PLATING OPTION (LEAD FREE)
4	MOUNTING PLATE		2	PLATING : MATTE TIN 1.5um min (LEAD FREE) NICKEL UNDER PLATING 1.27um min.


n : NO. OF CONTACTS

NOTES

- THIS PRODUCT IS THE TOP CONTACT TYPE CONNECTOR DESIGNED TO TERMINATE FPC/FFC AND COPES WITH AUTOMATIC MOUNTING (SMT).
- FLATNESS OF CONTACT TERMINAL AND MOUNTING PLATE TO HOUSING MUST BE WITHIN TOLERANCE IN Z PORTION DETAILED DRAWING.
- THIS PRODUCT MEETS EUROPEAN UNION DIRECTIVES AND OTHER COUNTRY REGULATIONS AS DESCRIBED IN GS47-0004.
- THE HOUSING WILL WITHSTAND EXPOSURE TO 260°C PEAK TEMPERATURE FOR 10 SECONDS IN A REFLOW SOLDERING OVEN.
- APPLICATION SPEC : BJM-SFV101. PRODUCT SPEC : REFER TO PLATING OPTION TABLE.
- CATALOG NUMBER STRUCTURE IS AS FOLLOWINGS.

PLATING OPTION TABLE

PRODUCT NUMBER	PLATING OPTION	CONTACT PLATING	TERMINAL PLATING	PRODUCT SPEC
SFV__R-2ST__HLF	BRANK	MATTE THIN TIN PLATING	MATTE TIN : 1um min.	GS-12-645
<del>SFV__R-2STA__HLF</del>	<del>A</del>	<del>GOLD : 0.05um min.</del>	<del>MATTE TIN : 1.5um min.</del>	<del>SC-SFV08</del>
SFV__R-2STB__HLF	B	GOLD : 0.05um min. WITH Ni DAM	GOLD : 0.05um min.	SC-SFV08

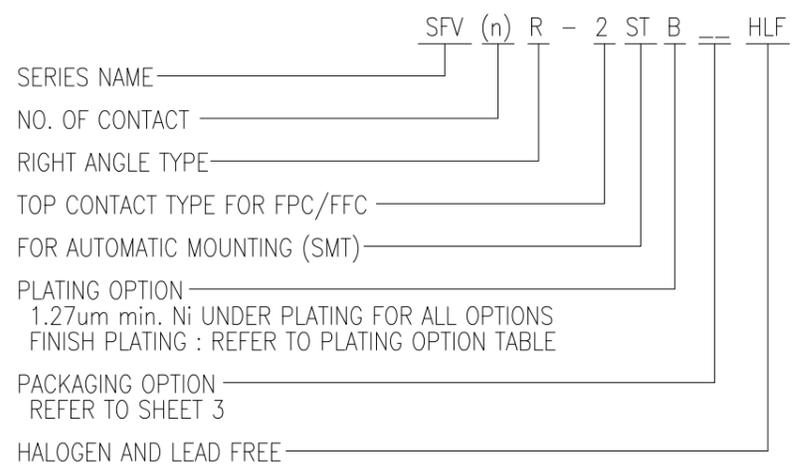

mat'l. code	surface	tolerance	projection	product family
SEE_TABLE	ISO 1302 ✓	ISO 406 ISO 1101		58EF
ltr	ecn no	dr	date	title
B				CONNECTOR USED FOR FPC/FFC WITH 0.5MM CONTACT SPACING (Cat. No. SFV__R-2ST__HLF)
				dwg no
				10171070
				sheet 4 of 6
				size A3
				type
				PRODUCT CUSTOMER DRAWING
sheet index	revision sheet			




© 2016 AFCI

RECOMMENDED CABLE (FFC)

(NOTE1, NOTE2)

n : NO. OF CONDUCTORS

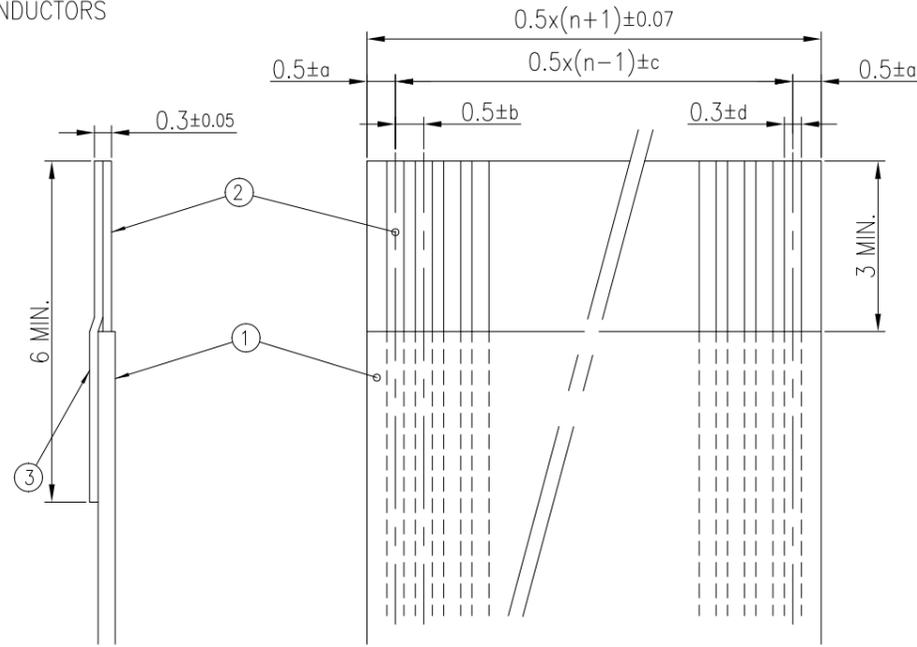


(NOTE4)	a	b	c	d
1	±0.07	±0.04	±0.05	±0.02
2	±0.1	±0.03	±0.03	±0.025

PT. NO.	DESCRIPTION	MATERIAL
1	INSULATOR	FLAME RESISTING POLYESTER OR EQUIVALENT
2	CONDUCTOR	COPPER FOIL (PLATING : TIN OR GOLD) (NOTE5)
3	SUPPORTING TAPE	FLAME RESISTING POLYESTER OR EQUIVALENT

RECOMMENDED CABLE (FPC)

(NOTE1, NOTE2)


n : NO. OF CONDUCTORS

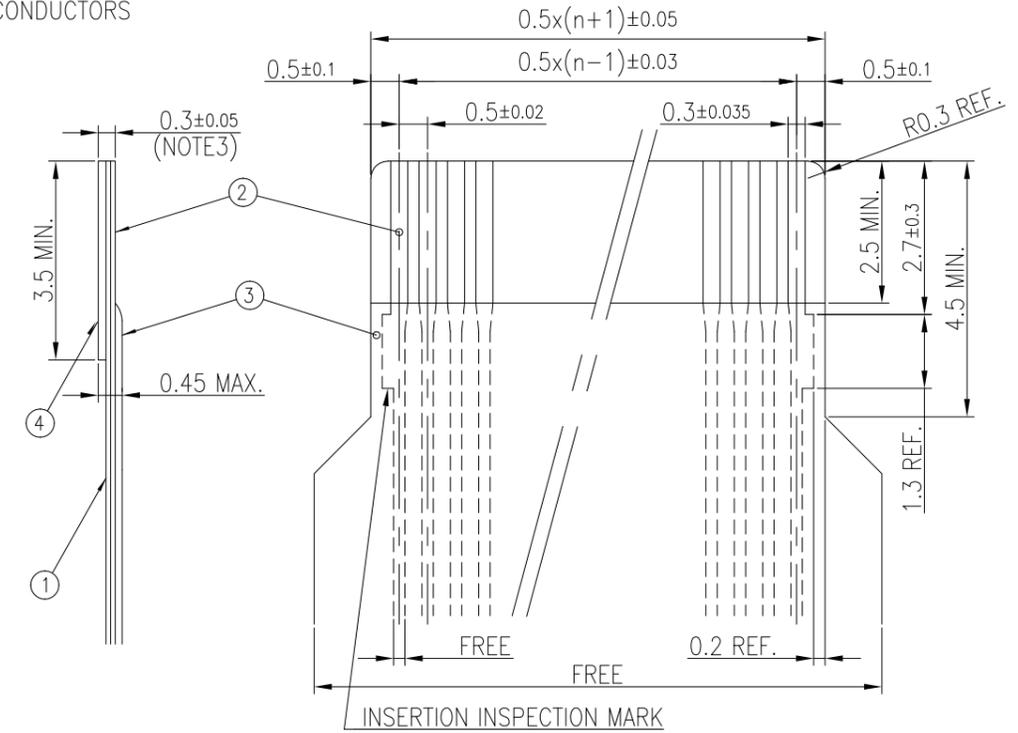

PT. NO.	DESCRIPTION	MATERIAL	THICKNESS (um)
1	BASE FILM	POLYIMIDE OR POLYESTER OR EQUIVALENT	25
2	CONDUCTOR	COPPER FOIL (PLATING : TIN OR GOLD) (NOTE5)	35
3	OVERLAY	POLYIMIDE OR POLYESTER OR EQUIVALENT	—
4	SUPPORTING TAPE	POLYESTER OR POLYIMIDE OR EQUIVALENT	188

RECOMMENDED PC BOARD LAYOUT

(COMPONENT SIDE) (NOTE6, NOTE7)

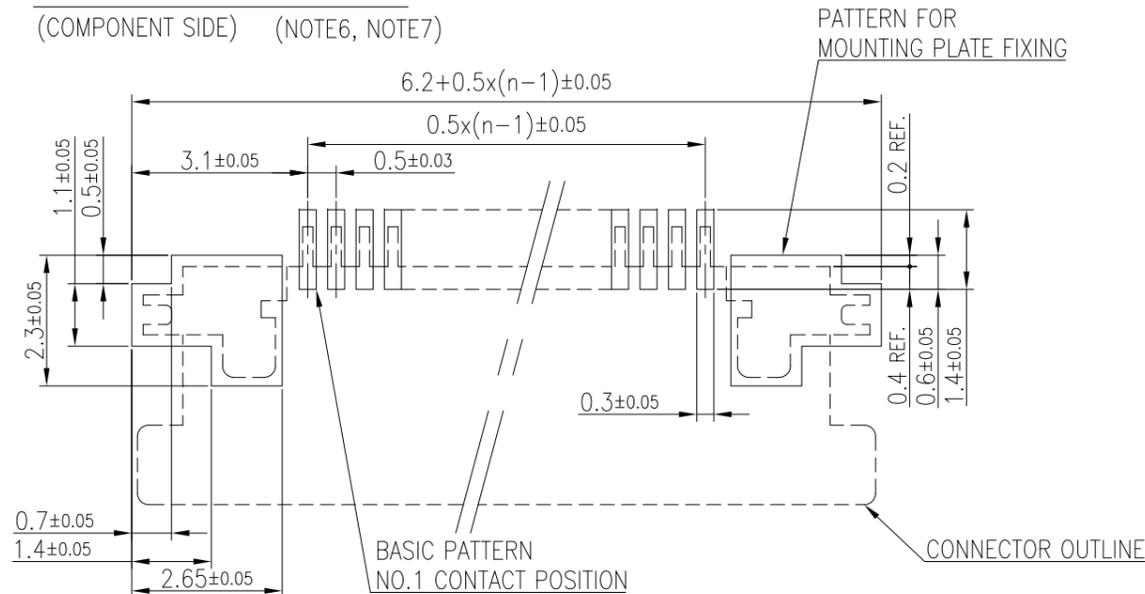

NOTES

1. NO BURR AT EACH PORTION.
2. NO PEELING IN COMMON USE.
3. TOTAL THICKNESS LIMIT OF EACH MATERIAL (INCLUDING ADHESIVE AGENT) IS SPECIFIED.
4. BOTH COMBINATIONS ARE ALLOWED.
5. FINISH PLATING OF CABLE CONDUCTOR AND CONTACT SHOULD BE MATCHED.
6. RECOMMENDED STENCIL THICKNESS IS 120~150um.
7. RECOMMENDED STENCIL OPENING RATIO IS 100%.

mat'l. code		surface		tolerance		projection		product family	
SEE_TABLE		ISO 1302	ISO 406	ISO 1101			58EF		
ltr	ecn no	dr	date	tolerances unless otherwise specified				title	
B				angles	linear	MM		RECOMMENDED CABLE AND PCB	
				0°±2'	0.X/±0.3	scale 8:1		(Cat. No. SFV__R-1/2ST_E1HLF)	
					0.XX/±0.3			dwg no	
				dr	S.WATANABE	2024-07-12			sheet 5 of 6
				enr	S.WATANABE	2024-07-12	10171070		A3
				chr	AN.MOHHAMAD-NABEEL	2024-07-12	type		PRODUCT CUSTOMER DRAWING
				app	Y.KAMEDA	2024-07-12			
sheet index	revision sheet								

# SFV\_R SERIES PREFERRED PART NUMBERS


## BOTTOM CONTACT / GOLD PLATING

 Preferred Part	NO. OF CONT (n)	CAT. NO.
●	4	SFV4R-1STBE1HLF
●	5	SFV5R-1STBE1HLF
●	6	SFV6R-1STBE1HLF
●	7	SFV7R-1STBE1HLF
●	8	SFV8R-1STBE1HLF
	9	SFV9R-1STBE1HLF
●	10	SFV10R-1STBE1HLF
	11	SFV11R-1STBE1HLF
●	12	SFV12R-1STBE1HLF
	13	SFV13R-1STBE1HLF
●	14	SFV14R-1STBE1HLF
●	15	SFV15R-1STBE1HLF
●	16	SFV16R-1STBE1HLF
	17	SFV17R-1STBE1HLF
●	18	SFV18R-1STBE1HLF
	19	SFV19R-1STBE1HLF
●	20	SFV20R-1STBE1HLF
	21	SFV21R-1STBE1HLF
●	22	SFV22R-1STBE1HLF
●	23	SFV23R-1STBE1HLF
●	24	SFV24R-1STBE1HLF
	25	SFV25R-1STBE1HLF
●	26	SFV26R-1STBE1HLF
●	27	SFV27R-1STBE1HLF
●	28	SFV28R-1STBE1HLF
	29	SFV29R-1STBE1HLF
●	30	SFV30R-1STBE1HLF
●	31	SFV31R-1STBE1HLF
●	32	SFV32R-1STBE1HLF
●	33	SFV33R-1STBE1HLF
	34	SFV34R-1STBE1HLF
●	35	SFV35R-1STBE1HLF

## TOP CONTACT / GOLD PLATING

 Preferred Part	NO. OF CONT (n)	CAT. NO.
●	4	SFV4R-2STBE1HLF
●	5	SFV5R-2STBE1HLF
●	6	SFV6R-2STBE1HLF
●	7	SFV7R-2STBE1HLF
●	8	SFV8R-2STBE1HLF
●	9	SFV9R-2STBE1HLF
●	10	SFV10R-2STBE1HLF
	11	SFV11R-2STBE1HLF
●	12	SFV12R-2STBE1HLF
	13	SFV13R-2STBE1HLF
●	14	SFV14R-2STBE1HLF
●	15	SFV15R-2STBE1HLF
●	16	SFV16R-2STBE1HLF
●	17	SFV17R-2STBE1HLF
●	18	SFV18R-2STBE1HLF
	19	SFV19R-2STBE1HLF
●	20	SFV20R-2STBE1HLF
●	21	SFV21R-2STBE1HLF
●	22	SFV22R-2STBE1HLF
●	23	SFV23R-2STBE1HLF
●	24	SFV24R-2STBE1HLF
●	25	SFV25R-2STBE1HLF
●	26	SFV26R-2STBE1HLF
	27	SFV27R-2STBE1HLF
	28	SFV28R-2STBE1HLF
	29	SFV29R-2STBE1HLF
●	30	SFV30R-2STBE1HLF
●	31	SFV31R-2STBE1HLF
●	32	SFV32R-2STBE1HLF
●	33	SFV33R-2STBE1HLF
	34	SFV34R-2STBE1HLF
●	35	SFV35R-2STBE1HLF

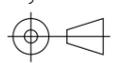

mat'l. code SEE_TABLE		surface ISO 1302 <input checked="" type="checkbox"/>		tolerance ISO 406 ISO 1101		projection 		product family 58EF	
ltr	ecn no	dr	date	tolerances unless otherwise specified		MM		title PREFERRED PART NUMBERS (Cat. No. SFV__R-1/2ST_E1HLF)	
B				angles	linear	scale N/A		dwg no 10171070	
				dr	S.WATANABE	2024-07-12		sheet 6 of 6	
				enr	S.WATANABE	2024-07-12		size A3	
				chr	AN.MOHHAMAD-NABEEL	2024-07-12		type PRODUCT CUSTOMER DRAWING	
				appd	Y.KAMEDA	2024-07-12			
sheet index	revision sheet								